1 - GUIDANCE SECTION 6 (LAST UPDATED 09/06/2024)

- NGS - [redacted] - [redacted] (MACDONALD MILLER, HVE, IMEG (FORMERLY RUSHING CO), HOLADAY-PARKS) IN ORDER TO EXPEDITE THE CREATION OF THESE SAMPLE PLANS. ANY INADVERTENT REFERENCE TO A SPECIFIC PROJECT IS PURELY COINCIDENTAL

NOTE: SOME OF THE [redacted] HAS BEEN [redacted] BY OUR [redacted]

TIPS FOR USING EXAMPLE PLANS:

6X ← SEARCH THE PDF (CTRL+F) TO FIND A SPECIFIC PLAN REVIEW DESIGN GUIDANCE REFERENCE.

? ← HOVER OVER QUESTION MARK FOR ADDITIONAL INFORMATION. DOUBLE-CLICK TO OPEN FULL TEXT BOX.

NOTE: NOT ALL GUIDANCE ITEMS ARE CURRENTLY REFLECTED ON AVAILABLE EXAMPLE PLANS

CURRENT DESIGN GUIDANCE:
https://cdn.kingcounty.gov/-/media/king-county/depts/dph/documents/health-safety/environmental-health/plumbing-gas-piping/plumbing-design-guidance.pdf

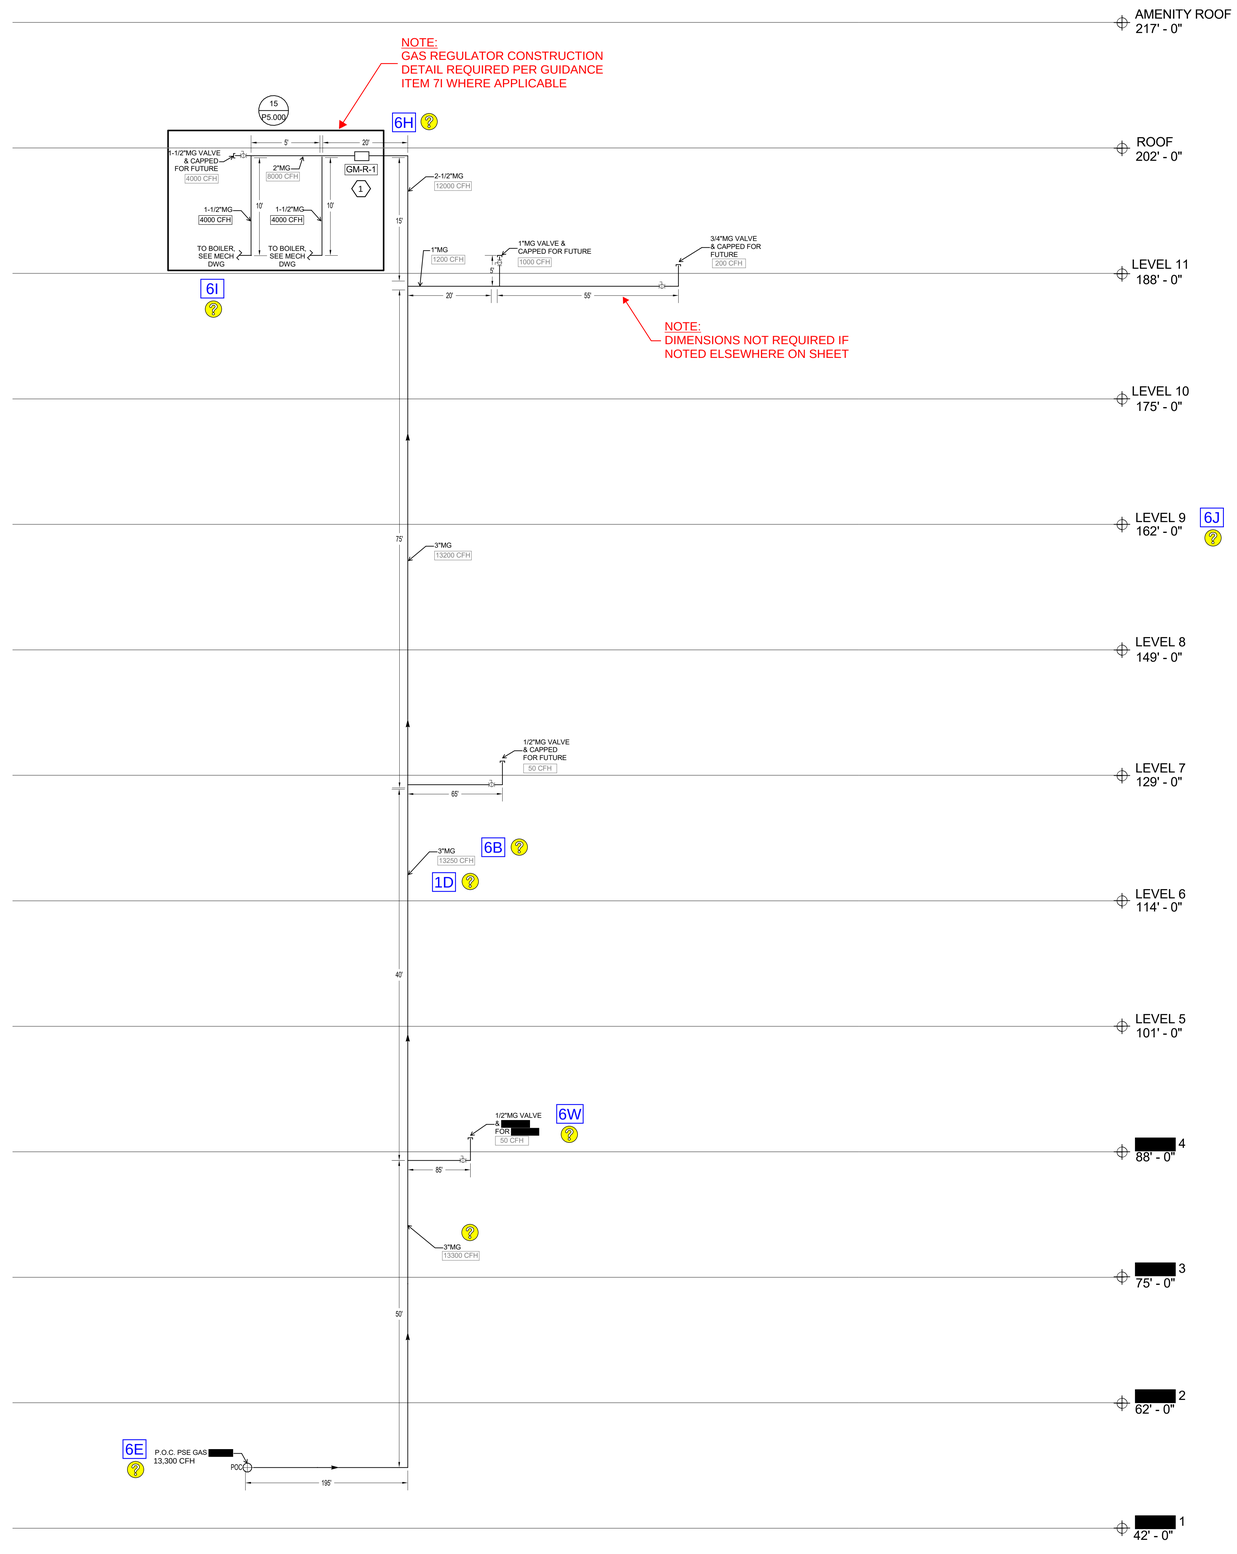

[redacted] GAS [redacted] DIAGRAM

GENERAL NOTES

1. UNLESS OTHERWISE INDICATED, SYSTEM LOADING IS DENOTED IN CUBIC FEET PER HOUR OF NATURAL GAS (CFH).
2. NATURAL GAS SYSTEM DESIGN BASED UPON IFGC/SFGC 402.4.3 'HYBRID PRESSURE' METHOD.
3. [redacted] OF [redacted] OF [redacted] /SF [redacted]
4. [redacted] OF [redacted] X. 5

6N

[redacted] NOTES

1. [redacted] WITH [redacted] C

NOTE: [redacted] ARE NOT [redacted] LA [redacted] T D [redacted] OF PL [redacted] O [redacted]

NAME AND LOGO

CONTACT INFORMATION

[redacted] FIRM

NAME AND LOGO

CONTACT INFORMATION

[redacted] OF RECORD

JOHN DOE
STATE OF WASHINGTON
REGISTERED PROFESSIONAL ENGINEER

DATE

EXAMPLE PROJECT
PROJECT ADDR
PROJECT CITY, [redacted] ZIP

REVISION [redacted]

DATE	REV	[redacted]
DD/MM/YY	X	[redacted]

[redacted]

[redacted] DATE

[redacted] GAS RAM

SCALE: NTS

[redacted]

P5.31